




The illustrative maps below show the existing and proposed Conservation Area, commencing at the Harecastle Tunnel in the north and terminating at Barlaston to the south. The <u>red line</u> shows the existing/ current boundary of the Conservation Area and the <u>blue line</u> indicates the proposed alterations. An interactive map is also available at <u>Stoke-on-Trent City Council Constraints Maps</u>.

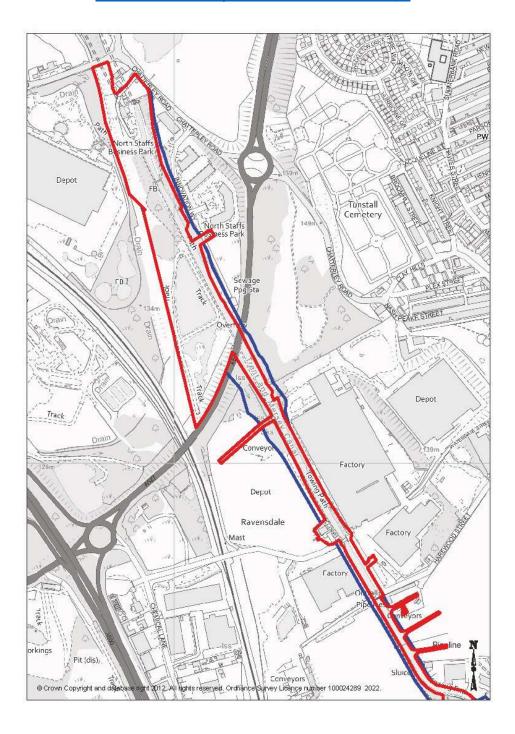


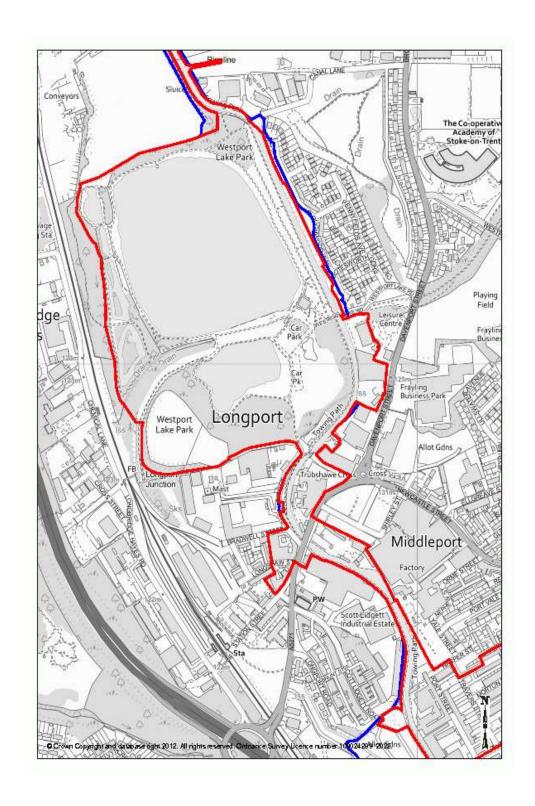


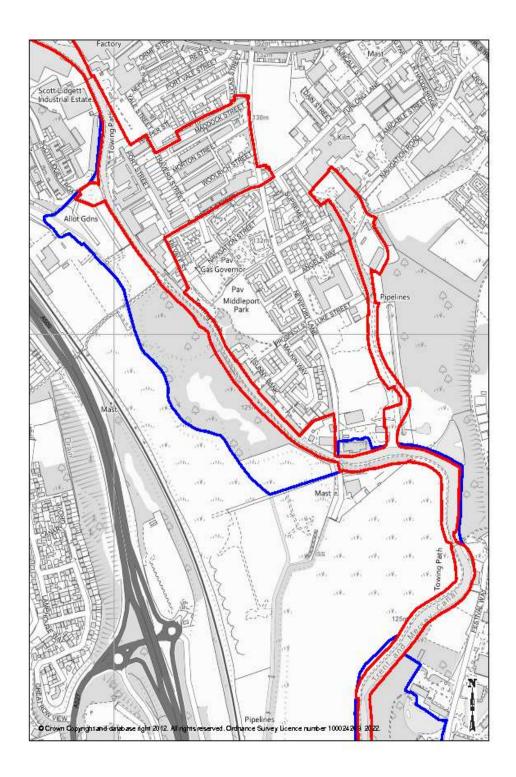


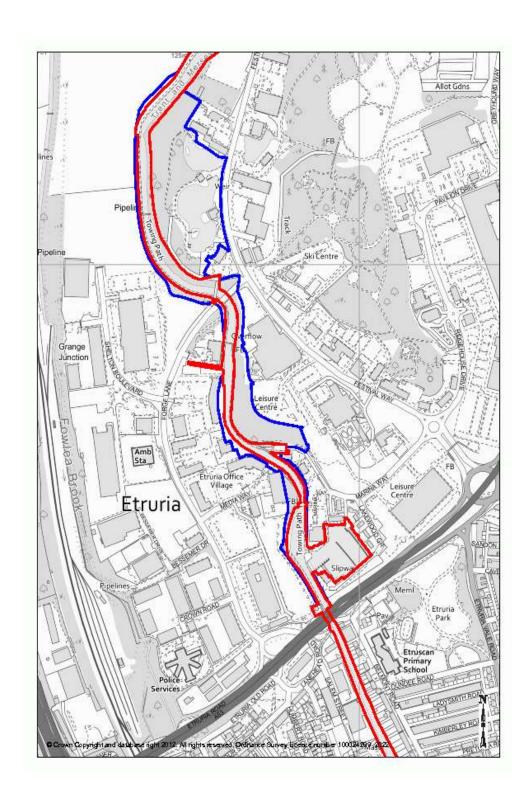


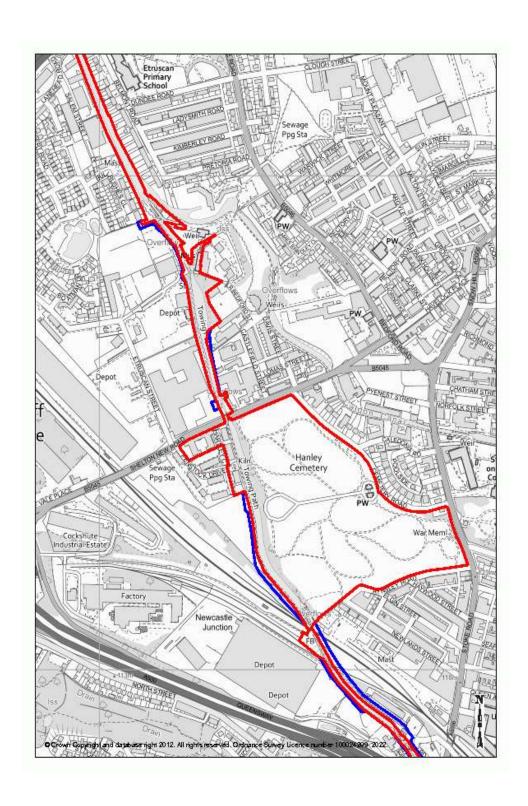


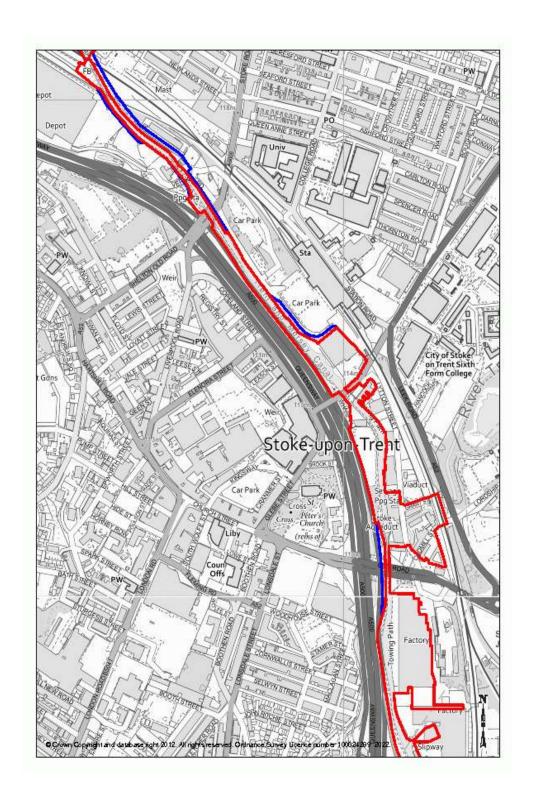


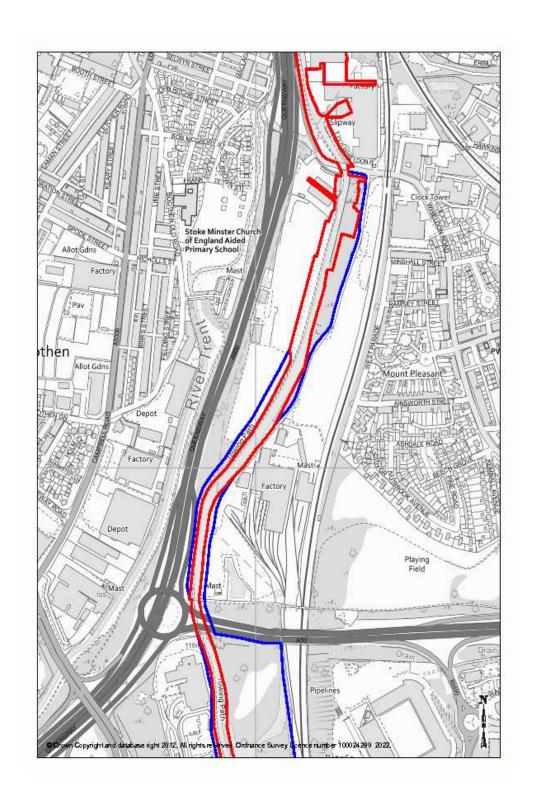

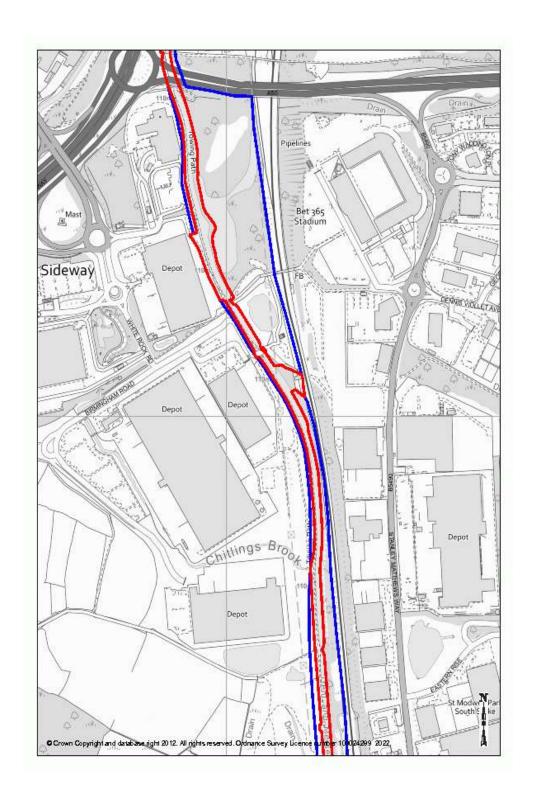

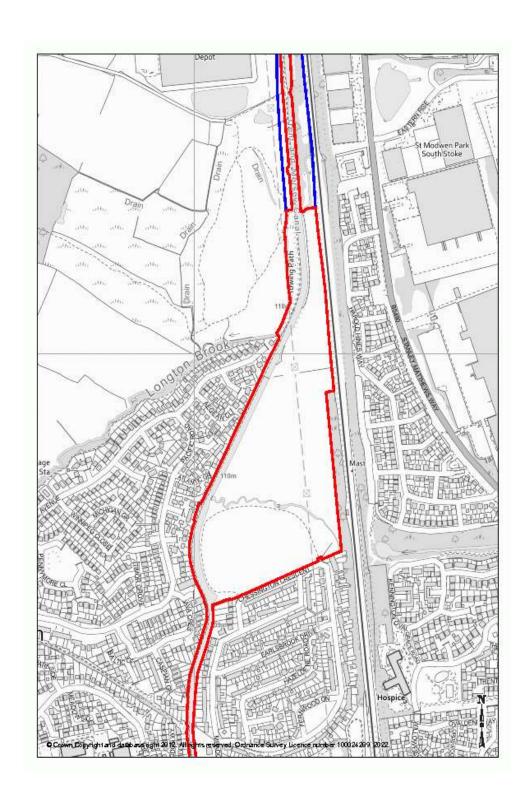

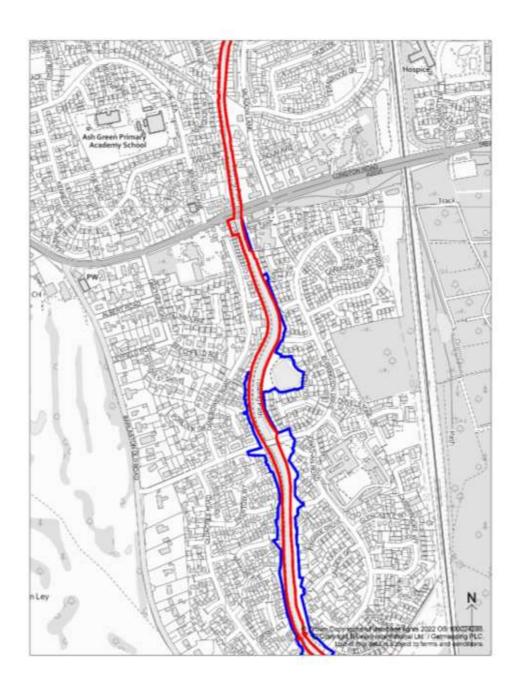

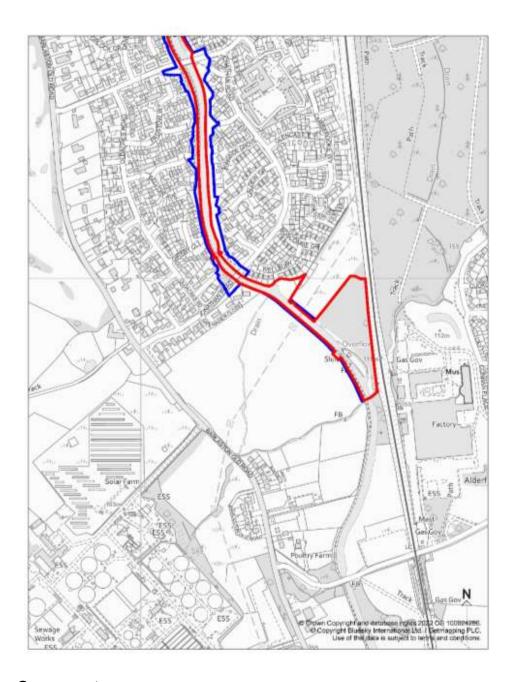

## **Comments**

If you wish to make any comments on the proposals set out above for the Trent and Mersey Canal Conservation Area please go to <a href="Online Consultation Portal">Online Consultation Portal</a> or complete the consultation response form to provide any comments.